

- GENERAL NOTES:**
- Client: Sunshine Housing
 - Location: Gall Street, Fairlie
 - Horizontal Datum: NZGD 2000 Timaru Circuit
 - Vertical Datum: Lyttelton 1937
 - All dimensions are in meters (m) unless shown otherwise.
 - This plan has been prepared for the sole purpose of providing as-built information to Timaru District Council.
 - Use of this plan for other purposes or its reproduction are not permitted.
 - New services installed on existing infrastructure (not shown)

- Sewer Pipe
- Water Pipe
- Stormwater Pipe
- Sewer Manhole
- Toby Boxes
- Stormwater Manhole
- Fire Hydrant
- Gate Valve

Rev	Details	Date
A	Preliminary	3.05.23

Company Name & Address



© ROONEY EARTHMOVING LTD
 Hilton Highway,
 Washdyke, Timaru
 PH: (03) 687 4699

Project

SUNSHING HOUSING LTD
GALL STREET
FAIRLIE

3 WATERS ASBUILT

Drawn By	M.J.L	Drawing No.	D001
Date	3/05/2023		
Scale	1:500 @ A3		

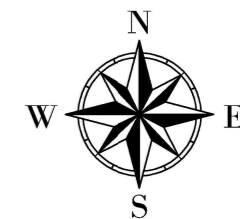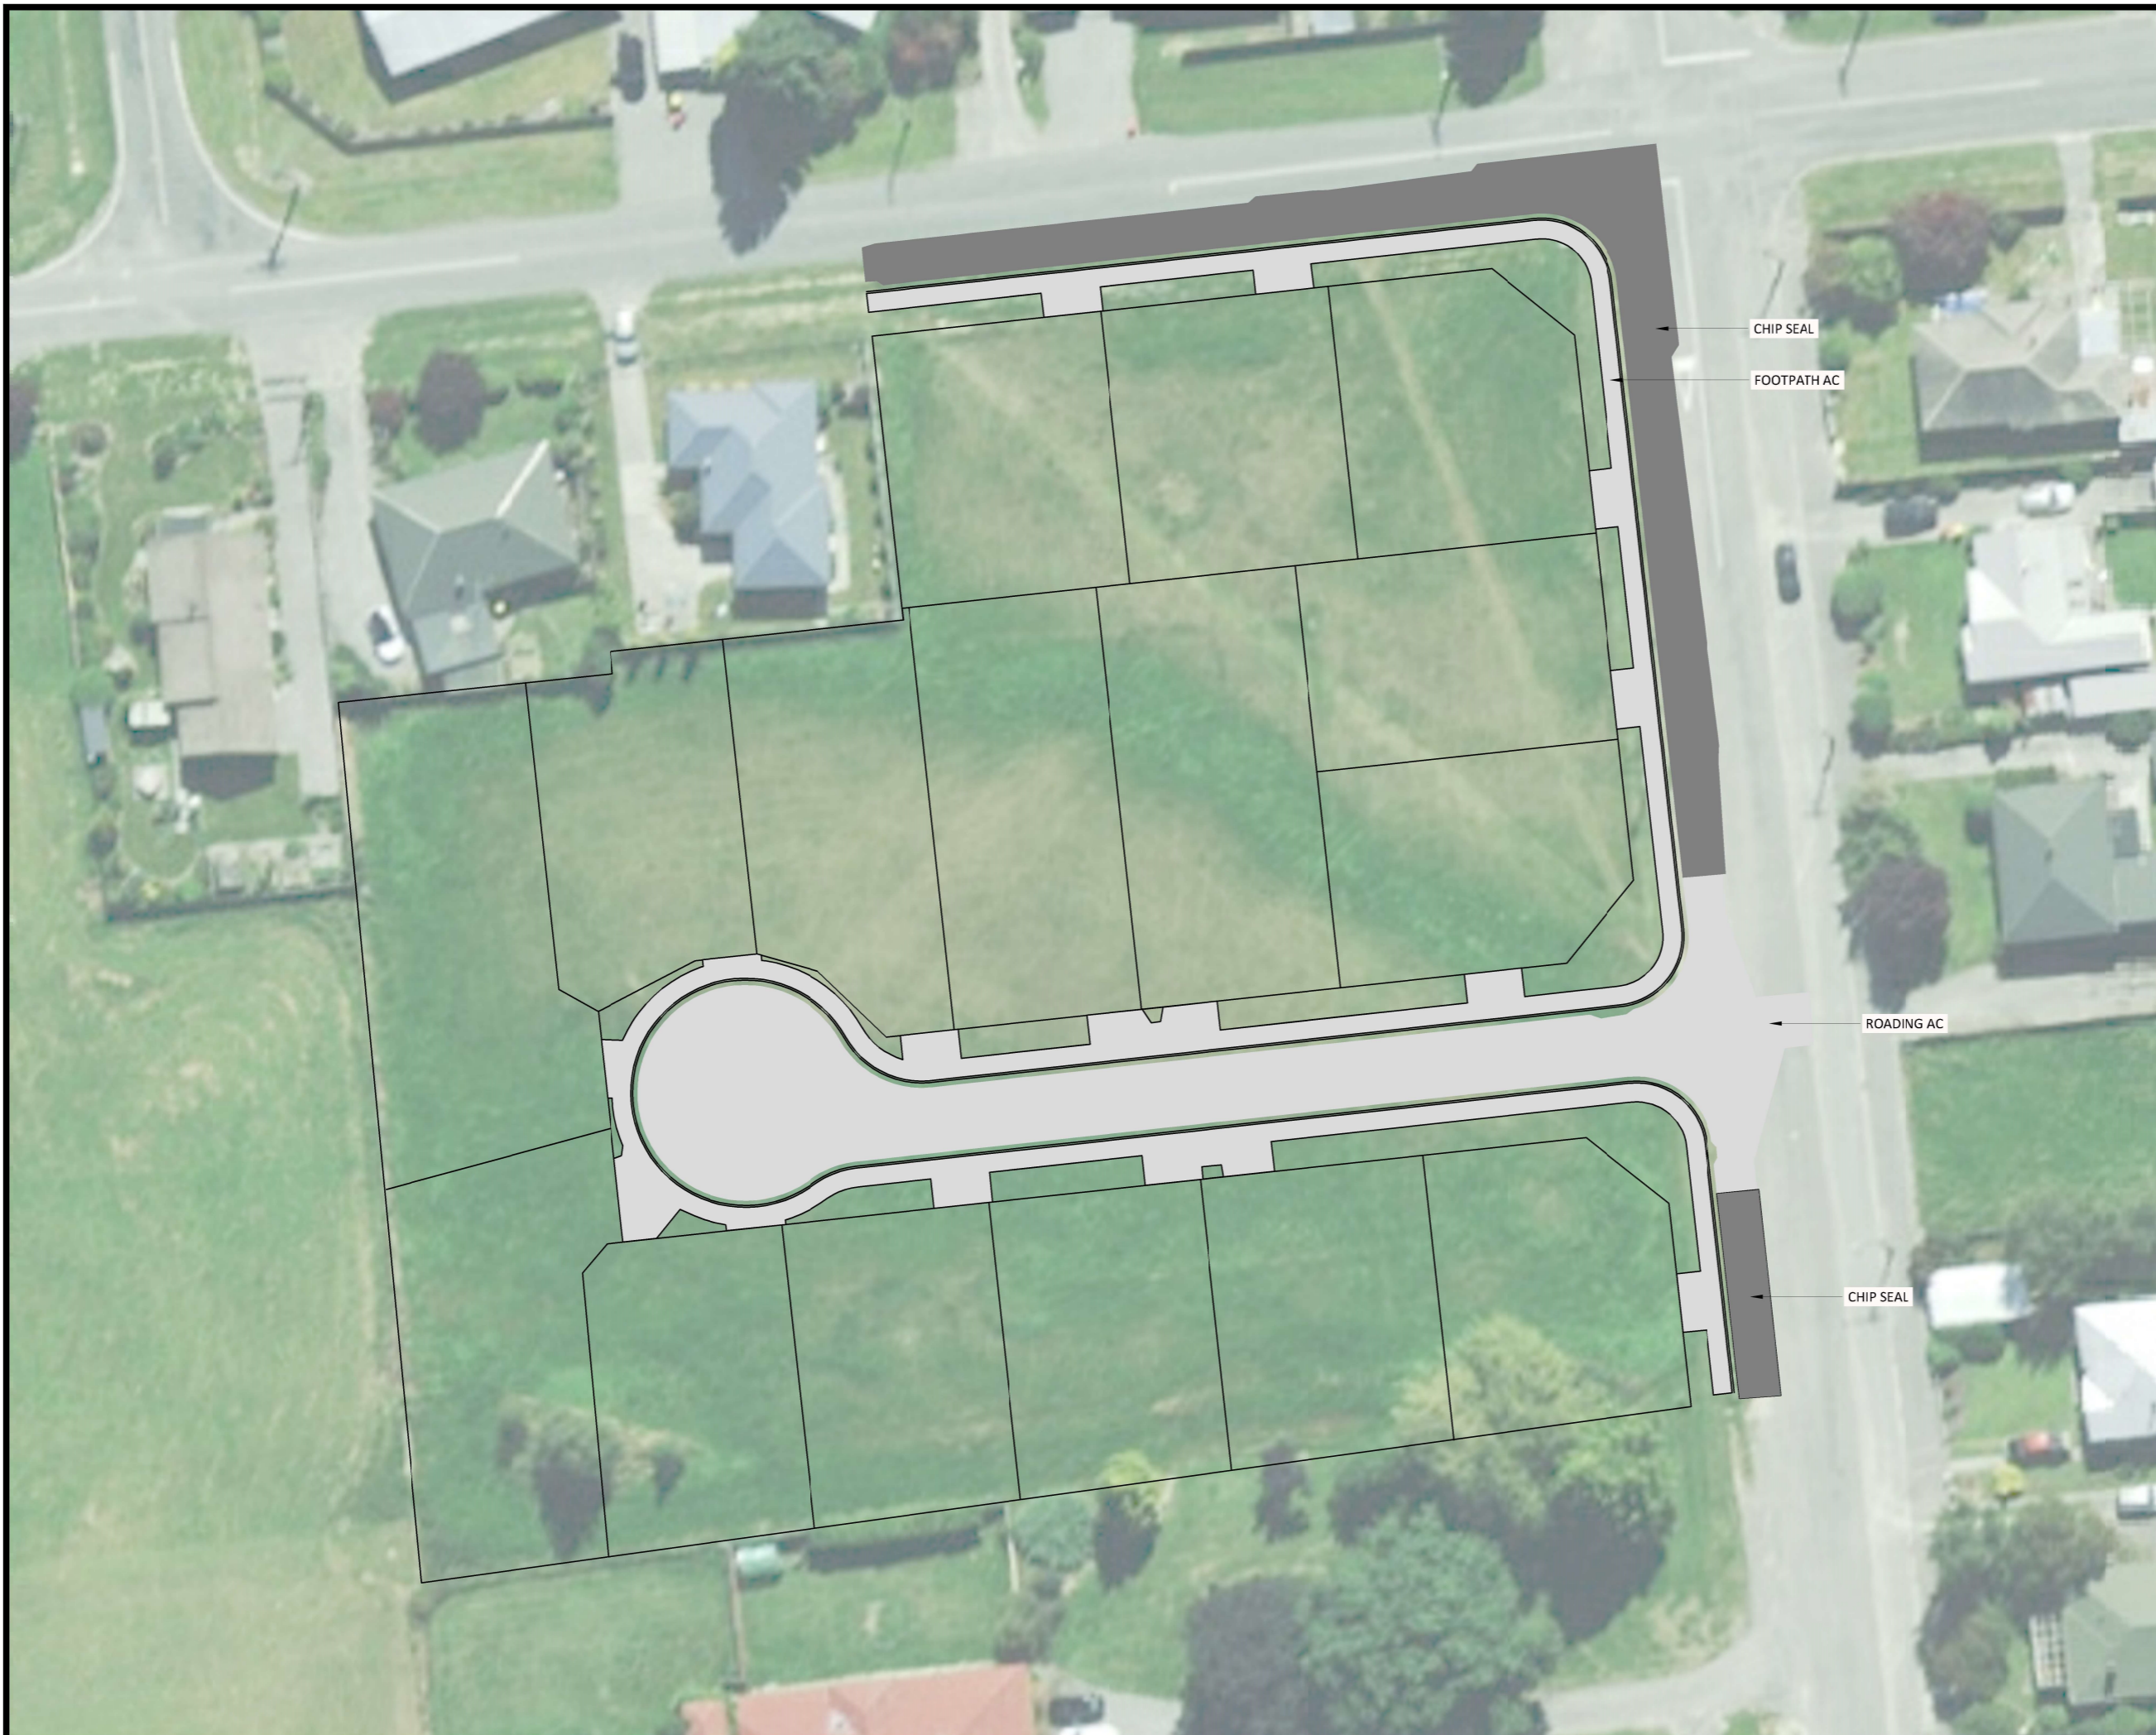


GENERAL NOTES:

- Client: Sunshing Housing
 Location: Gall Street, Fairlie
 Horizontal Datum: NZGD 2000 Timaru Circuit
 Vertical Datum: Lytelton 1937
- All dimensions are in meters (m) unless shown otherwise.
 - Aerial Photography sourced from Canterbury Maps.
 - Boundary Information sourced from LINZ online data service & Canterbury Maps Rating Units.
 - This plan has been prepared for the sole purpose of providing as-built information to Timaru District Council.
 - Use of this plan for other purposes or its reproduction are not permitted.
 - Roading AC - 743m²
 - Footpath AC - 636m²
 - Chipseal - 516m²

Rev	Details	Date
A	Preliminary	19.04.23

Company Name & Address




© ROONEY EARTHMOVING LTD
 Hilton Highway,
 Washdyke, Timaru
 PH: (03) 687 4699

Project

SUNSHINE HOUSING LTD
 GALL STREET
 FAIRLIE

SEAL AREA PLAN

Drawn By	M.J.L	Drawing No.	SA001
Date	19/04/2023		
Scale	1:500 @ A3		

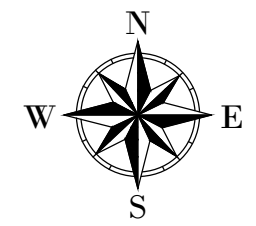

GENERAL NOTES:

- Client: Sunshine Housing
 Location: Gall Street, Fairlie
 Horizontal Datum: NZGD 2000 Timaru Circuit
 Vertical Datum: Lyttelton 1937
- All dimensions are in meters (m) unless shown otherwise.
 - This plan has been prepared for the sole purpose of providing as-built information to Timaru District Council.
 - Use of this plan for other purposes or its reproduction are not permitted.

- Chorus, Alpine Energy and Water
- Chorus and Alpine Energy
- Chorus only
- Alpine Energy
- DBox
- Street Light

A	Preliminary	3.05.23
Rev	Details	Date

Company Name & Address



© ROONEY EARTHMOVING LTD
 Hilton Highway,
 Washdyke, Timaru
 PH: (03) 687 4699

Project

SUNSHING HOUSING LTD
 GALL STREET
 FAIRLIE

SERVICE ASBUILT

Drawn By	M.J.L	Drawing No.	S001
Date	3/05/2023		
Scale	1:500 @ A3		